

LABOR AND MATERIALS


1	Copper Lead	Connection	3/4	\$	
1	Curb	Cock Valve T.S. & V.	3/4 in.	\$	
1	Service box	Short	3 1/2 x 4 1/2	\$	
	Old returned	Long	4 1/2 x 5 1/2	\$	
13 or 14	Ft.	Copper G.I. C.I.	3/4 in.	Pipe at	\$
	Nipples	in.	at	\$	
	Bushings	to	in.	at	\$
	Red'g Inc'g	Coupl'gs	to	in.	at
	Union	in.	at	\$	
	Meter	in.	at	\$	
	Compound Joints	at	\$		
	Maintenance Foreman	\$			
	Hrs. Water Maint. Man-1	at	\$		
	Hrs. Water Maint. Man-2	at	\$		
	Hrs. Garage Foreman	at	\$		
	Hrs. Labor	at	\$		
	Hrs. Compressor	at	\$		
	Trucking	\$			
	Pav't Patch	\$			
		\$			
		\$			
BAY

St. ~~Pl.~~ No. 229  
Ave. No.

Name of Owner  
TAX ID # 302.12-3-12

Labor and Mat'l. Report DEC 19 33

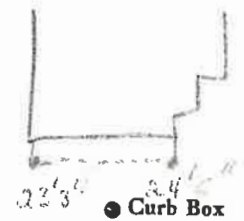

6" Main Elev. of Main at tap 5 1/2'

Gate at ● Gate at ●

● Curb Box

ONE TAP SHUT OFF AT MAIN