

LABOR AND MATERIALS


1	Copper	Connection	<u>3/4</u>		\$
	Lead				
1	Curb	Cock Valve	}	in.	\$
		T.S. & V.			
1	Service box	Short 3 1/2 x 4 1/2	}		
	Old returned	Long 4 1/2 x 5 1/2			
		Buff or Rdway			\$
<u>35</u>	<u>Ft.</u>	<u>3/4</u>	in.	Copper Pipe at	\$
				C.I.	
				C.I.	
	Nipples	in.	at		\$
	Bushings	to	in.	at	\$
	Red'g	}			
	Inc'g				
	Coupl'gs	to	in.	at	\$
	Union	in.	at		\$
	Meter	in.	at		\$
	Lead Joints	at			\$
	Compound Joints	at			\$
	Maintenance Foreman				\$
	Hrs. Water Maint. Man-1	at			\$
	Hrs. Water Maint. Man-2	at			\$
	Hrs. Garage Foreman	at			\$
	Hrs. Labor	at			\$
	Hrs. Compressor	at			\$
	Compensation Ins.	at \$	per C		\$
	Trucking				\$
	Pav't Patch				\$
					\$
					\$
	O'head				\$
					\$

St. Pl. Ave. No. 68

BAY

Name of Owner _____

Labor and Mat'l. Report 19

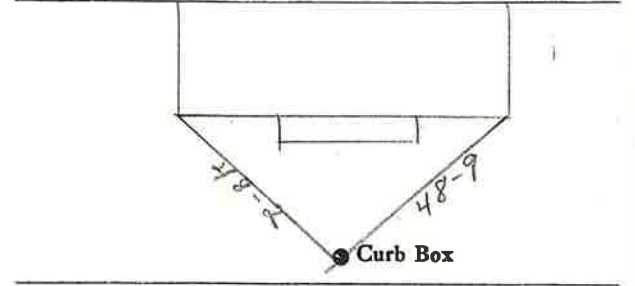

10 Main Elev. of Main at tap 5

Gate at • • Gate at

● Curb Box

MAY NOT BE ACTIVE

LABOR AND MATERIALS


Copper	Lead	Connection		\$	
Curb	}	Cock	} in.	\$	
		Valve			
		T. S. & V.			
Service box	}	Short 3½ x 4½	}	\$	
		Long 4½ x 5½			
Old returned					
Ft. 2	in.	{ Copper	} Pipe at	\$	
		G.I.			
		C.I.			
Nipples	in.	at		\$	
Bushings	to	in.	at	\$	
Red'g	}	Coupl'gs	to in.	at	\$
Inc'g					
Union	in.	at		\$	
Meter	in.	at		\$	
				\$	
Compound Joints	at			\$	
Maintenance Foreman				\$	
Hrs. Water Maint. Man-1	at			\$	
Hrs. Water Maint. Man-2	at			\$	
Hrs. Garage Foreman	at			\$	
Hrs. Labor	at			\$	
Hrs. Compressor	at			\$	
				\$	
Trucking				\$	
Pav't Patch				\$	
				\$	
				\$	
				\$	
				\$	

BAY

St.
~~Pl.~~
Aver No. 68

Name of Owner
SYNAGOGUE

Labor and Mat'l. Report 1992

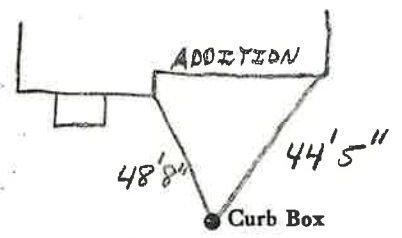

	Elev. of
..... Main	Main at tap
Gate at ●	● Gate at

● Curb Box