

LABOR AND MATERIALS

1	Copper } Connection $\frac{3}{4}$	\$
1	Lead } Cock	\$
1	Curb } Valve } $\frac{3}{4}$ in.	\$
	} T.S. & V. }	
1	Service box } Short $3\frac{1}{2} \times 4\frac{1}{2}$	\$
Old returned	Long $4\frac{1}{2} \times 5\frac{1}{2}$	
	Buff or Rdway	
10	Ft. $\frac{3}{4}$ in. } Copper	\$
	} C.I.	
	} C.I. } Pipe at	
	Nipples in. at	\$
	Bushings to in. at	\$
	Red'g } Coupl'gs to in. at	\$
	Inc'g }	
	Union in. at	\$
	Meter in. at	\$
	Lead Joints at	\$
	Compound Joints at	\$
	Maintenance Foreman	\$
	Hrs. Water Maint. Man-1 at	\$
	Hrs. Water Maint. Man-2 at	\$
	Hrs. Garage Foreman at	\$
	Hrs. Labor at	\$
	Hrs. Compressor at	\$
	Compensation Ins. at \$ per C	\$
	Trucking	\$
	Pay't Patch	\$
		\$
		\$
		\$
	O'head	\$
		\$


BAY

St. Pl. Ave. No. 71

Name of Owner

Labor and Mat'l. Report

19

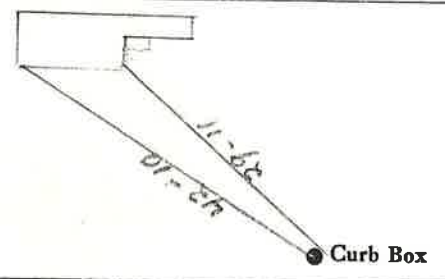

10 Main

Elev. of Main at tap $5\frac{1}{2}$

Gate at ●

● Gate at

● Curb Box