

LABOR AND MATERIALS

1	Copper Lead	Connection	3/4	\$
1	Curb	Cock Valve T.S. & V.	3/4 in.	\$
	Service box	Short 3 1/2 x 4 1/2 Long 4 1/2 x 5 1/2 Buff or Rdway		\$
	Old returned			\$
1 8	Ft. in.	Copper G.I. G.I.	Pipe at	\$
	Nipples	in.	at	\$
	Bushings	to	in. at	\$
	Red'g Inc'g	Coupl'gs	to in. at	\$
	Union	in.	at	\$
	Meter	in.	at	\$
	Lead Joints			\$
	Compound Joints			\$
	Maintenance Foreman			\$
	Hrs. Water Maint. Man	1	at	\$
	Hrs. Water Maint. Man	2	at	\$
	Hrs. Garage Foreman		at	\$
	Hrs. Labor		at	\$
	Hrs. Compressor		at	\$
	Compensation Ins.	at \$	per C	\$
	Trucking			\$
	Pav't Patch			\$
				\$
				\$
				\$
	O'head			\$
				\$


Bay St

St. PL. Ave. No. 72

Name of Owner

Labor and Mat'l. Report

April 1 1925

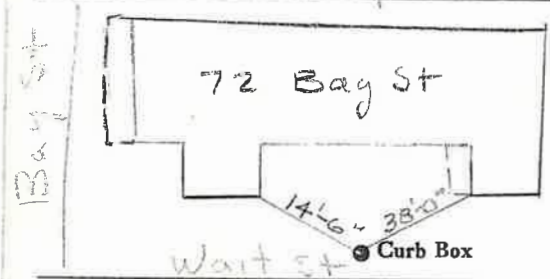

Main

Elev. of Main at tap

Gate at ●

● Gate at

TAX ID # 302.20-17-2W

● Curb Box

Re-measured 6-24-75