


### LABOR AND MATERIALS

1	Copper Lead	} Connection	<u>3/4</u>		\$
1	Curb	} Cock Valve	} <u>3/4</u> in.		\$
		} T.S. & V.			
1	Service box	}	Short $3\frac{1}{2}$ x $4\frac{1}{2}$	\$	
	Old returned		Long $4\frac{1}{2}$ x $5\frac{1}{2}$		
			Buff or Rdway		
10	Ft. <u>3/4</u> in.	}	Copper	\$	
			<del>S.I.</del>		Pipe at
			<del>C.I.</del>		
	Nipples	in. at		\$	
	Bushings	to in. at		\$	
	Red'g	} Coupl'gs	to in. at	\$	
	Inc'g				
	Union	in. at		\$	
	Meter	in. at		\$	
	Lead Joints	at		\$	
	Compound Joints	at		\$	
	Maintenance Foreman			\$	
	Hrs. Water Maint. Man-1	at		\$	
	Hrs. Water Maint. Man-2	at		\$	
	Hrs. Garage Foreman	at		\$	
	Hrs. Labor	at		\$	
	Hrs. Compressor	at		\$	
	Compensation Ins.	at \$	per C	\$	
	Trucking			\$	
	Pav't Patch			\$	
				\$	
				\$	
				\$	
	O'head			\$	
				\$	

St.  
Pl.  
Ave. No. 85

BAY  
Name of Owner

Labor and Mat'l. Report 19 81

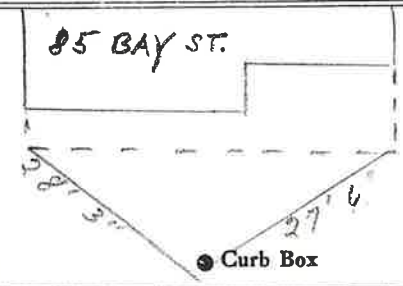

10" Main Elev. of Main at tap 4 1/2

Gate at ● ● Gate at

● Curb Box