

### LABOR AND MATERIALS


1	Copper Lead	} Connection	<u>3/4</u>		\$		
1	Curb	} Cock Valve T.S. & V.	} <u>3/4</u> in.		\$		
1	Service box Old returned	{ Short $3\frac{1}{2} \times 4\frac{1}{2}$ Long $4\frac{1}{2} \times 5\frac{1}{2}$ Buff or Rdway			\$		
11	Ft. <u>3/4</u> in.	{ Copper C.I. C.I.	} Pipe at		\$		
	Nipples	in. at			\$		
	Bushings	to in. at			\$		
	Red'g Inc'g	Coupl'gs to in. at			\$		
	Union	in. at			\$		
	Meter	in. at			\$		
	Lead Joints at				\$		
	Compound Joints at				\$		
	Maintenance Foreman				\$		
	Hrs. Water Maint. Man-1 at				\$		
	Hrs. Water Maint. Man-2 at				\$		
	Hrs. Garage Foreman at				\$		
	Hrs. Labor at				\$		
	Hrs. Compressor at				\$		
	Compensation Ins. at \$	per C			\$		
	Trucking				\$		
	Pav't Patch				\$		
					\$		
					\$		
	O'head				\$		
					\$		

St.  
Pl.  
Ave. No. 91

BAY

Name of Owner \_\_\_\_\_

Labor and Mat'l. Report 19

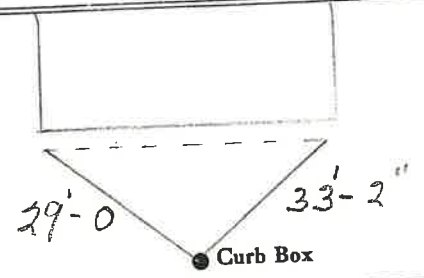

10" Main Elev. of Main at tap 6'

Gate at ● ● Gate at

● Curb Box