


LABOR AND MATERIALS

1	Copper	} Connection	3/4"	\$
	Lead			
1	Curb	} Cock Valve	3/4 in. (original)	\$
1	Service box	} Short 3 1/2 x 4 1/2		\$
	Old returned			
11	Ft. 3/4 in.	} Copper	Pipe at	\$
	Nipples		in. at	\$
	Bushings		to in. at	\$
	Red'g			\$
	Inc'g	} Coupl'gs	to in. at	\$
	Union		in. at	\$
	Meter		in. at	\$
	Lead Joints at			\$
	Compound Joints at			\$
	Maintenance Foreman			\$
	Hrs. Water Maint. Man-1 at			\$
	Hrs. Water Maint. Man-2 at			\$
	Hrs. Garage Foreman at			\$
	Hrs. Labor at			\$
	Hrs. Compressor at			\$
	Compensation Ins. at \$		per C	\$
	Trucking			\$
	Pav't Patch			\$
				\$
	TAP MADE BY DONAVAN			
	+ CO			
	O'head		July 6-1972	\$
				\$

BAY ST. St. No. 93

Name of Owner Feigenbaum

Labor and Mat'l. Report July 6 1972

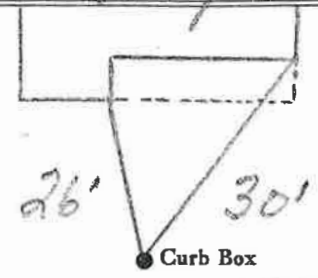

10" Main Elev. of Main at tap 5'

Gate at • • Gate at

TAX ID # 302.20-9-16

• Curb Box