


St. PL  
 Ave. No. 94

Name of Owner  
 TAX ID # 302.20-8-4

Labor and Mat'l. Report 19

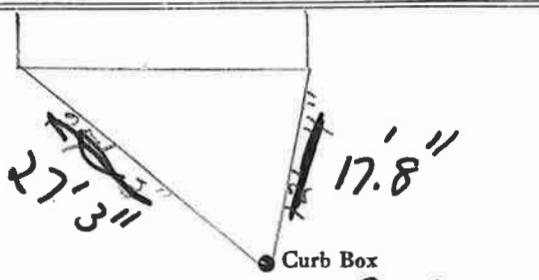


*Goodwin Ave*

4" Main Elev. of Main at tap 5

Gate at • • Gate at

● Curb Box

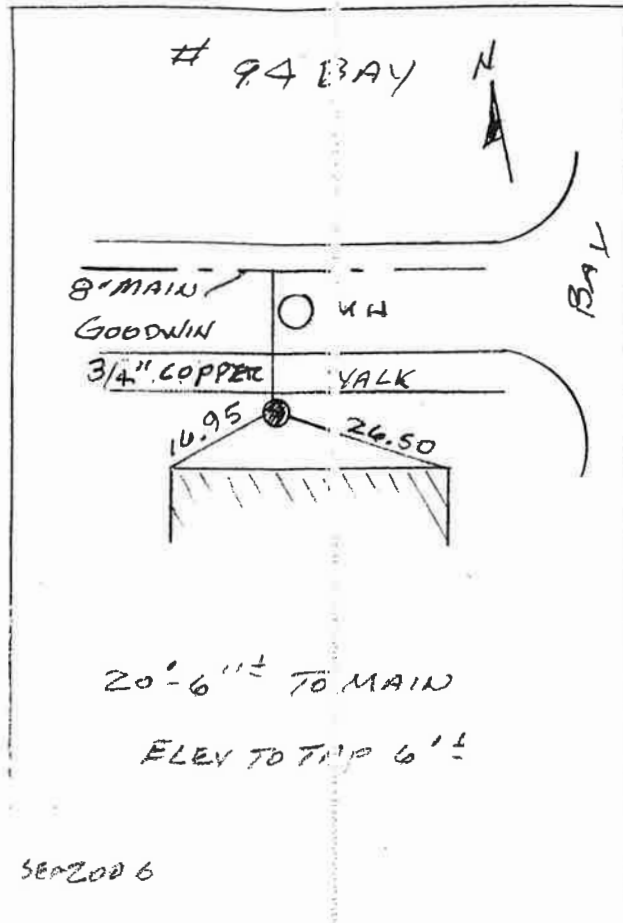

SEP 2006

LABOR AND MATERIALS

1	Copper Lead	Connection	<u>3/4</u>	\$
1	Curb	Cock Valve T.S. & V.	<u>3/4 in.</u>	\$
1	Service box Old returned	Short 3 1/2 x 4 1/2 Long 4 1/2 x 5 1/2 Buff or Rdway		\$
20	Ft. in.	Copper G.I. C.I.	Pipe at	\$
	Nipples	in. at		\$
	Bushings	to in. at		\$
	Red'g Inc'g	Coupl'gs to in. at		\$
	Union	in. at		\$
	Meter	in. at		\$
	Lead Joints at			\$
	Compound Joints at			\$
	Maintenance Foreman			\$
	Hrs. Water Maint. Man-1	at		\$
	Hrs. Water Maint. Man-2	at		\$
	Hrs. Garage Foreman	at		\$
	Hrs. Labor	at		\$
	Hrs. Compressor at			\$
	Compensation Ins. at \$	per C		\$
	Trucking			\$
	Pav't Patch			\$
	O'head			\$