

LABOR AND MATERIALS


1 Copper } Connection $\frac{3}{4}$ \$ _____
 1 Lead }
 1 Curb } Cock } $\frac{3}{4}$ in. \$ _____
 } Valve }
 } T.S. & V. }
 1 Service box { Short $3\frac{1}{2}$ x $4\frac{1}{2}$ }
 Old returned { Long $4\frac{1}{2}$ x $5\frac{1}{2}$ } \$ _____
 } Buff. or Rdway }
 33 Ft. $\frac{3}{4}$ in. { Copper } Pipe at \$ _____
 } C.I. }
 } C.I. }
 Nipples _____ in. at \$ _____
 Bushings _____ to _____ in. at \$ _____
 Red'g } Coupl'gs _____ to _____ in. at \$ _____
 Inc'g }
 Union _____ in. at \$ _____
 Meter _____ in. at \$ _____
 Lead Joints at \$ _____
 Compound Joints at \$ _____
 Maintenance Foreman \$ _____
 Hrs. Water Maint. Man—1 at \$ _____
 Hrs. Water Maint. Man—2 at \$ _____
 Hrs. Garage Foreman _____ at \$ _____
 Hrs. Labor _____ at \$ _____
 Hrs. Compressor at \$ _____
 Compensation Ins. at \$ _____ per C \$ _____
 Trucking \$ _____
 Pay't Patch \$ _____
 _____ \$ _____
 _____ \$ _____
 _____ \$ _____
 O'head \$ _____
 _____ \$ _____

St. _____
 Pl. _____
 Ave. No. 96

BAY

Name of Owner _____
 TAX ID # 302.20-6-1

Labor and Mat'l. Report 19

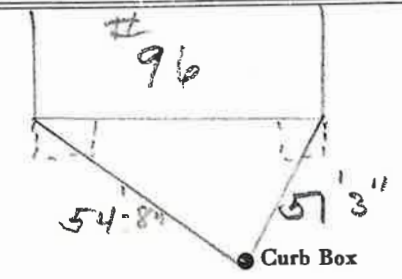

Main Elev. of Main at tap _____
 Gate at • • Gate at _____

 • Curb Box