


LABOR AND MATERIALS

1	Copper Lead	Connection	$\frac{3}{4}$	\$
1	Curb	Cock Valve T.S. & V.	$\frac{3}{4}$ in.	\$
1	Service box Old returned	Short $3\frac{1}{2} \times 4\frac{1}{2}$ Long $4\frac{1}{2} \times 5\frac{1}{2}$ Buff or Rdway		\$
9	Ft.	$\frac{3}{4}$ in. Copper G.I. Pipe at		\$
	Nipples	in. at		\$
1	Bushings	$\frac{3}{4}$ to in. at		\$
	Red'g Inc'g	Coupl'gs to in. at		\$
	Union	in. at		\$
	Meter	in. at		\$
	Lead Joints	at		\$
	Compound Joints	at		\$
	Maintenance Foreman			\$
	Hrs. Water Maint. Man-1	at		\$
	Hrs. Water Maint. Man-2	at		\$
	Hrs. Garage Foreman	at		\$
	Hrs. Labor	at		\$
	Hrs. Compressor	at		\$
	Compensation Ins.	at \$ per C		\$
	Trucking			\$
	Pav't Patch			\$
	O'head			\$

St. Pl. Ave. No. 97
Bay
 Name of Owner

Labor and Mat'l. Report 19

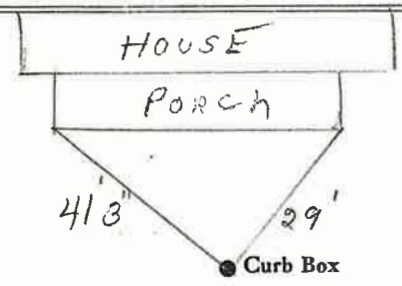

12 Main Elev. of Main at tap 5'

Gate at • Gate at •

TAX ID #302.20-9-14

• Curb Box

"On" is "off" for curb box

SEWER GOES TO FULTON