


LABOR AND MATERIALS

Copper	} Connection	_____	\$ _____	
Lead				
Curb	} Cock } Valve } T. S. & V.	_____ in.	\$ _____	
Service box		} Short 3 1/2 x 4 1/2 } Long 4 1/2 x 5 1/2		
Old returned				\$ _____
9 Ft.	} Copper } G. I. } G. I.	1 in. Pipe at	\$ _____	
Nipples		in. at	\$ _____	
Bushings		to _____ in. at	\$ _____	
Red'g Inc'g	} Coupl'gs	to _____ in. at	\$ _____	
Union		in. at	\$ _____	
Meter	in. at	\$ _____		
Compound Joints	at	\$ _____		
Maintenance Foreman		\$ _____		
Hrs. Water Maint. Man-1	at	\$ _____		
Hrs. Water Maint. Man-2	at	\$ _____		
Hrs. Garage Foreman	at	\$ _____		
Hrs. Labor	at	\$ _____		
Hrs. Compressor	at	\$ _____		
Trucking		\$ _____		
Pav't Patch		\$ _____		
		\$ _____		
		\$ _____		
St. 98 Bay
 Pl. _____
 Ave. No. 98

Name of Owner Jeff Pearl

Labor and Mat'l. Report Nov 19 87

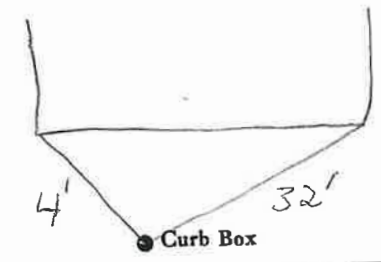

	Main	Elev. of Main at tap
Gate at	•	• Gate at
TAX ID # 302.20-6-2		

Tap on Goodwin
Ave.