


LABOR AND MATERIALS

1	Copper Lead	} Connection	<u>3/4</u>	\$
1	Curb		} <u>3/4</u> in.	\$
1	Service box	} { Short 3 1/2 x 4 1/2 Long 4 1/2 x 5 1/2 Buff or Rdway }		\$
	Old returned			\$
				\$
37	Ft. <u>3/4</u> in.	} { Copper G.I. C.I. }	Pipe at	\$
				\$
	Nipples	in. at		\$
	Bushings	to in. at		\$
	Red'g Inc'g	} Coupl'gs	to in. at	\$
	Union		in. at	\$
	Meter	in. at	\$	
	Lead Joints	at	\$	
	Compound Joints	at	\$	
	Maintenance Foreman		\$	
	Hrs. Water Maint. Man-1	at	\$	
	Hrs. Water Maint. Man-2	at	\$	
	Hrs. Garage Foreman	at	\$	
	Hrs. Labor	at	\$	
	Hrs. Compressor	at	\$	
	Compensation Ins.	at \$ per C	\$	
	Trucking		\$	
	Pav't Patch		\$	
			\$	
			\$	
	O'head		\$	
			\$	

BAY St. Pl. Ave. No. 100
 Name of Owner
 TAX ID # 302.20-6-3

Labor and Mat'l. Report 19

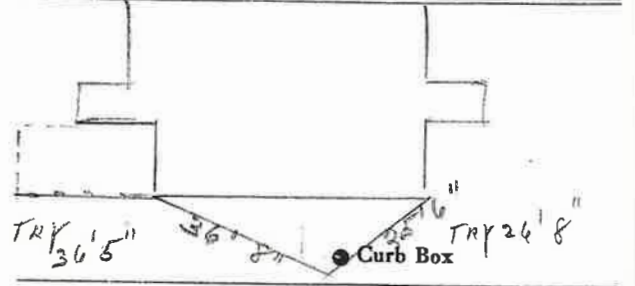

10 Main Elev. of Main at tap 5
 Gate at • Gate at

• Curb Box

LABOR AND MATERIALS


1	Copper Lead } Connection	3/4	\$
1	Curb } Cock Valve } T.S. & V. }	3/4 in.	\$
1	Service box Old returned	{ Short 3-1/2 x 5-1/2 } { Long 4-1/2 x 5-1/2 }	\$
37	Ft. 3/4 in. { Copper } { C.I. }	Pipe at	\$
	Nipples	in. at	\$
	Bushings	to in. at	\$
	Red'g		
	Inc'g		
	Union	in. at	\$
	Meter	in. at	\$
			\$
	Compound Joints at		\$
	Maintenance Foreman		\$
	Hrs. Water Maint. Man - 1 at		\$
	Hrs. Water Maint. Man - 2 at		\$
	Hrs. Garage Foreman	at	\$
	Hrs. Labor	at	\$
	Hrs. Compressor at		\$
			\$
	Trucking		\$
	Pav't Patch		\$
			\$
			\$
			\$
			\$

BAY

St. Pl. Ave. No. 100

Name of Owner

Labor and Mat'l. Report ~~X~~ 02-25-2003

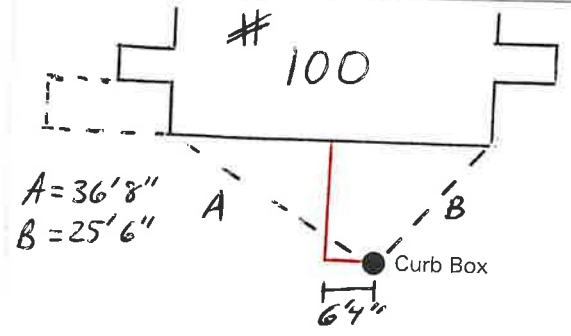

10 Main Elev. of Main at tap 5

Gate at ● Gate at ●

FROM CURB BOX, PIPING GOES 6 FT 4" LEFT.

● Curb Box

THE WATER SERVICE IS "L" SHAPED.
* WHEN SERVICE IS ON IT WILL APPEAR TO BE IN THE OFF POSITION.

ALSO TRY - A=36'5" B=26'8"