

LABOR AND MATERIALS

1	<del>Lead</del> Copper	Connection	$\frac{3}{4}$	\$
1	Curb	Cock Valve T. S. & V.	$\frac{3}{4}$ in.	\$
1	Service box <del>Old returned</del>	Short $3\frac{1}{2} \times 4\frac{1}{2}$ Long $4\frac{1}{2} \times 5\frac{1}{2}$ Buff. or Rdway		\$
9	Ft. $\frac{3}{4}$ in.	Copper <del>C.I.</del> C.I.	Pipe at	\$
	Nipples	in. at		\$
	Bushings	to in. at		\$
	Red'g Inc'g	Coupl'gs	to in. at	\$
	Union	in. at		\$
	Meter	in. at		\$
	Lead Joints	at		\$
	Compound Joints	at		\$
	Maintenance Foreman			\$
	Hrs. Water Maint. Man	—1 at		\$
	Hrs. Water Maint. Man	—2 at		\$
	Hrs. Garage Foreman	at		\$
	Hrs. Labor	at		\$
	Hrs. Compressor	at		\$
	Compensation Ins.	at \$ per C		\$
	Trucking			\$
	Pav't Patch			\$
				\$
				\$
	O'head			\$
				\$


BAY

St. ~~Pl.~~  
Ave. No. 103

Name of Owner

Labor and Mat'l. Report

19

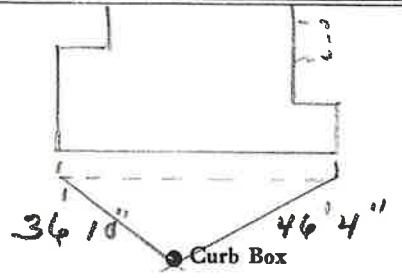

10 Main

Elev. of Main at tap 5

Gate at •

• Gate at

• Curb Box