

LABOR AND MATERIALS


1	Copper Lead	Connection	3/4	\$
1	Curb	Cock Valve T.S. & V.	3/4 in.	\$
1	Service box Old returned	Short 3 1/2 x 4 1/2 Long 4 1/2 x 5 1/2 Buff or Rdway		\$
12	Ft.	3/4 in. Copper G.I. C.I. Pipe at		\$
	Nipples	in. at		\$
	Bushings	to in. at		\$
	Red'g Inc'g	Coupl'gs to in. at		\$
	Union	in. at		\$
	Meter	in. at		\$
	Lead Joints at			\$
	Compound Joints at			\$
	Maintenance Foreman			\$
	Hrs. Water Maint. Man—1 at			\$
	Hrs. Water Maint. Man—2 at			\$
	Hrs. Garage Foreman at			\$
	Hrs. Labor— at			\$
	Hrs. Compressor at			\$
	Compensation Ins. at \$	per C.		\$
	Trucking			\$
	Pav't Patch			\$
	O'head			\$
				\$

St. Pl. Ave. No. 105

BAY
Name of Owner

TAX ID # 302.16-20-16

Labor and Mat'l. Report 19

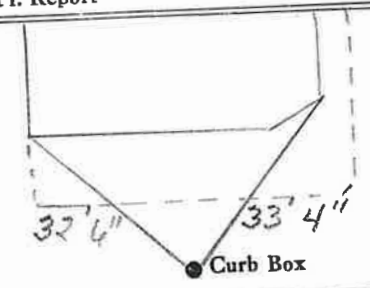

10" Main Elev. of Main at tap 5 1/2

Gate at ● ● Gate at

● Curb Box