


LABOR AND MATERIALS

1	Copper	} Connection $\frac{3}{4}$	\$
1	Lead		\$
1	Curb	} Cock Valve T.S. & V. } $\frac{3}{4}$ in.	\$
1	Service box		} Short $3\frac{1}{2} \times 4\frac{1}{2}$ Long $4\frac{1}{2} \times 5\frac{1}{2}$ Buff or Rdway }
	Old returned	\$	
9	Ft. $\frac{3}{4}$ in.	} Copper C.I. } Pipe at	\$
			\$
	Nipples	in. at	\$
	Bushings	to in. at	\$
	Red'g } Inc'g }	} Coupl'gs to in. at	\$
	Union		
	Meter	in. at	\$
	Lead Joints	at	\$
	Compound Joints	at	\$
	Maintenance Foreman		\$
	Hrs. Water Maint. Man-1	at	\$
	Hrs. Water Maint. Man-2	at	\$
	Hrs. Garage Foreman	at	\$
	Hrs. Labor	at	\$
	Hrs. Compressor	at	\$
	Compensation Ins.	at \$ per C	\$
	Trucking		\$
	Pav't Patch		\$
			\$
			\$
	O'head		\$
			\$

BAY St. Pl.
Ave. No. 107
Name of Owner
TAX ID # 302.16-20-15

Labor and Mat'l. Report 19

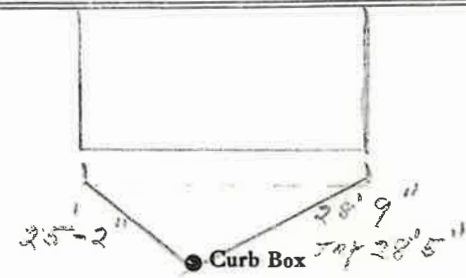

10 Main Elev. of Main at tap 5
Gate at • Gate at

• Curb Box