


LABOR AND MATERIALS

1	Copper Lead	Connection	<u>3/4</u>		\$
1	Curb	Cook Valve T.S. & V.	} <u>3/4</u> in.		\$
1	Service box Old returned	Short $3\frac{1}{2} \times 4\frac{1}{2}$ Long $4\frac{1}{2} \times 5\frac{1}{2}$ Buff or Rdway	}		\$
28	Ft.	<u>3/4</u> in. Copper G.I. G.I.	} Pipe at		\$
	Nipples	in. at			\$
	Bushings	to in. at			\$
	Red'g Inc'g	Coupl'gs. to in. at			\$
	Union	in. at			\$
	Meter	in. at			\$
	Lead Joints	at			\$
	Compound Joints	at			\$
	Maintenance Foreman				\$
	Hrs. Water Maint. Man-1	at			\$
	Hrs. Water Maint. Man-2	at			\$
	Hrs. Garage Foreman	at			\$
	Hrs. Labor	at			\$
	Hrs. Compressor	at			\$
	Compensation Ins. at \$	per C			\$
	Trucking				\$
	Pav't Patch				\$
					\$
					\$
	O'head				\$
					\$

BAY St.
Pl. 110
Ave. No. 110

Name of Owner _____

Labor and Mat'l. Report 19

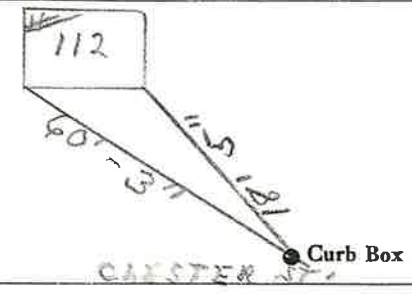

10 Main Elev. of
Main at tap 4 1/4

Gate at • • Gate at

● Curb Box

MEASURED
FROM 112 BAY ST
TAP ON CHESTER ST