


LABOR AND MATERIALS

1	Copper	Connection	<u>3/4</u>		\$	
	Lead					
1	Curb	Cock Valve	<u>3/4</u>	in.	\$	
		T.S. & V.				
1	Service box	}	Short $3\frac{1}{2} \times 4\frac{1}{2}$		\$	
	Old returned		Long $4\frac{1}{2} \times 5\frac{1}{2}$		\$	
			Buff or Rdway		\$	
8	Ft.	$\frac{3}{4}$ in.	Copper	}	Pipe at	\$
			G.I.			\$
			C.I.			\$
	Nipples	in.	at		\$	
	Bushings	to	in.	at	\$	
	Red'g	}				
	Inc'g					
	Union	in.	at		\$	
	Meter	in.	at		\$	
	Lead Joints	at			\$	
	Compound Joints	at			\$	
	Maintenance Foreman				\$	
	Hrs. Water Maint. Man-1	at			\$	
	Hrs. Water Maint. Man-2	at			\$	
	Hrs. Garage Foreman	at			\$	
	Hrs. Labor	at			\$	
	Hrs. Compressor	at			\$	
	Compensation Ins.	at \$	per C		\$	
	Trucking				\$	
	Pav't Patch				\$	
					\$	
					\$	
	O'head				\$	
					\$	

St.
Pl.
Ave. No. 114

Bay
Name of Owner
TAX ID # 302.16-12-1

Labor and Mat'l. Report 19

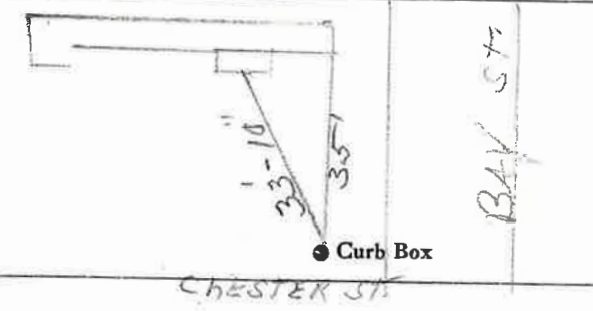

10 Main Elev. of Main at tap 4

Gate at ● ● Gate at

● Curb Box