


LABOR AND MATERIALS

1 Copper } Connection ^{3/4} \$ _____
 Lead }
 1 Curb } Cock } 3/4 in. \$ _____
 Valve }
 T.S. & V. }
 1 Service box { Short 3 1/2 x 4 1/2 }
 Old returned { Long 4 1/2 x 5 1/2 }
 Buff or Rdway } \$ _____
 33 Ft. 3/4 in. { Copper } Pipe at \$ _____
 C.I. }
 C.I. }
 Nipples _____ in. at \$ _____
 Bushings _____ to _____ in. at \$ _____
 Red'g }
 Inc'g } Coupl'gs _____ to _____ in. at \$ _____
 Union _____ in. at \$ _____
 Meter _____ in. at \$ _____
 Lead Joints at \$ _____
 Compound Joints at \$ _____
 Maintenance Foreman \$ _____
 Hrs. Water Maint. Man-1 at \$ _____
 Hrs. Water Maint. Man-2 at \$ _____
 Hrs. Garage Foreman _____ at \$ _____
 Hrs. Labor _____ at \$ _____
 Hrs. Compressor at \$ _____
 Compensation Ins. at \$ _____ per C \$ _____
 Trucking \$ _____
 Pav't Patch \$ _____
 \$ _____
 \$ _____
 \$ _____
 \$ _____
 O'head \$ _____
 \$ _____

St. _____
 Pt. _____
 Ave. No. 118

Name of Owner _____
 TAX ID # 302.16-12-3

Labor and Mat'l. Report _____ 19

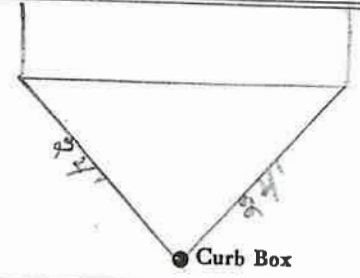

6" Main _____ Elev. of Main at tap 5'
 Gate at • _____ • Gate at _____

• Curb Box