


LABOR AND MATERIALS

1	Copper	} Connection	3/4	\$
1	Lead			
1	Curb	} Cock Valve T. S. & V.	3/4 in.	\$
1	Service box			
1	Old returned			
			{ Short 3 1/2 x 4 1/2 Long 4 1/2 x 5 1/2 Buff or Rdway }	\$
32	Ft. 3/4 in.	{ Copper G.I. G.I. }	} Pipe at	\$
	Nipples	in. at		\$
	Bushings	to in. at		\$
	Red'g	} Coupl'gs	to in. at	\$
	Inc'g			
	Union	in. at		\$
	Meter	in. at		\$
	Lead Joints	at		\$
	Compound Joints	at		\$
	Maintenance Foreman			\$
	Hrs. Water Maint. Man	1 at		\$
	Hrs. Water Maint. Man	2 at		\$
	Hrs. Garage Foreman	at		\$
	Hrs. Labor	at		\$
	Hrs. Compressor	at		\$
	Compensation Ins.	at \$ per C		\$
	Trucking			\$
	Pav't Patch			\$
				\$
				\$
	O'head			\$
				\$

By St.
~~Pl.~~ Ave. No. 120

Name of Owner
 TAX ID # 302.16-12-4

Labor and Mat'l. Report 19

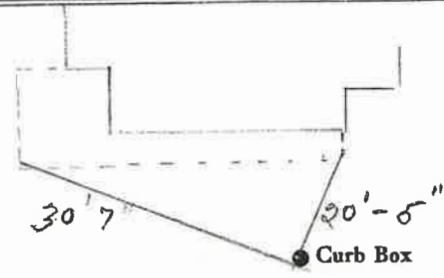

6 Main Elev. of Main at tap 5 1/2
 Gate at • • Gate at

• Curb Box

NOTE - CURB STOP-OFF
 POSITION IS ON and
 VICE VERSA