


LABOR AND MATERIALS

1 Copper } Connection 3/4 \$ _____
 Lead }
 1 Curb } Cock } in. 3/4 \$ _____
 } Valve }
 } T.S. & V. }
 1 Service box { Short $3\frac{1}{2} \times 4\frac{1}{2}$ }
 Old returned { Long $4\frac{1}{2} \times 5\frac{1}{2}$ } \$ _____
 } Buff or Rdway }
34 Ft. 3/4 in. { Copper } Pipe at _____ \$ _____
 } G.I. }
 } C.I. }
 Nipples in. at _____ \$ _____
 Bushings to _____ in. at _____ \$ _____
 Red'g }
 Inc'g } Coupl'gs to _____ in. at _____ \$ _____
 Union in. at _____ \$ _____
 Meter in. at _____ \$ _____
 Lead Joints at _____ \$ _____
 Compound Joints at _____ \$ _____
 Maintenance Foreman _____ \$ _____
 Hrs. Water Maint. Man-1 at _____ \$ _____
 Hrs. Water Maint. Man-2 at _____ \$ _____
 Hrs. Garage Foreman at _____ \$ _____
 Hrs. Labor- _____ at _____ \$ _____
 Hrs. Compressor at _____ \$ _____
 Compensation Ins. at \$ _____ per C. _____ \$ _____
 Trucking _____ \$ _____
 Pav't Patch _____ \$ _____
 _____ \$ _____
 _____ \$ _____
 _____ \$ _____
 _____ \$ _____
 O'head _____ \$ _____
 _____ \$ _____

BAY St. _____
 Ave. No. 132

Name of Owner _____
 TAX ID # 302.16-12-5

Labor and Mat'l. Report 19

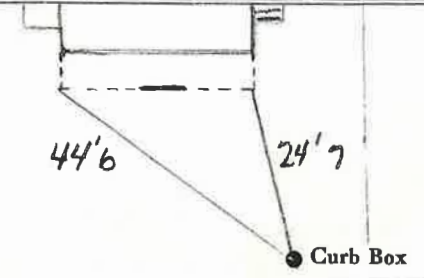

6 Main Elev. of Main at tap 5

Gate at ● Gate at ●

● Curb Box