


LABOR AND MATERIALS

1	Copper	} Connection $\frac{3}{4}$	\$
	Lead		
1	Curb	} $\frac{3}{4}$ in.	\$
	Cock		
	Valve		
		T.S. & V.	
1	Service box	{ Short $3\frac{1}{2} \times 4\frac{1}{2}$ Long $4\frac{1}{2} \times 5\frac{1}{2}$ Buff or Rdway }	\$
	Old returned		
10	Ft. $\frac{3}{4}$ in.	{ Copper C.I. C.I. }	Pipe at \$
	Nipples	in. at	\$
	Bushings	to in. at	\$
	Red'g	} Coupl'gs to in. at	\$
	Inc'g		
	Union	in. at	\$
	Meter	in. at	\$
	Lead Joints	at	\$
	Compound Joints	at	\$
	Maintenance Foreman		\$
	Hrs. Water Maint. Man	—1 at	\$
	Hrs. Water Maint. Man	—2 at	\$
	Hrs. Garage Foreman	at	\$
	Hrs. Labor	at	\$
	Hrs. Compressor	at	\$
	Compensation Ins.	at \$ per C	\$
	Trucking		\$
	Pav't Patch		\$
			\$
			\$
	O'head		\$
			\$

BAY St. Pl. Ave. No. 125

Name of Owner
TAX ID # 302.16-17-26

Labor and Mat'l. Report 19

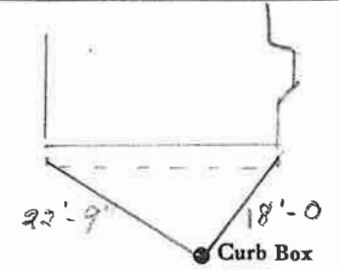

6 Main Elev. of Main at tap $5\frac{1}{2}$
Gate at • Gate at •

• Curb Box