


LABOR AND MATERIALS

1	Copper	} Connection	3/4	_____	\$ _____	
1	Lead					
1	Curb	} Cock Valve T.S. & V.	3/4 in.	_____	\$ _____	
1	Service box					
Old returned						
			Short 3 1/2 x 4 1/2			
			Long 4 1/2 x 5 1/2			
			Buff or Rdway		\$ _____	
13	Ft.	} Copper	3/4 in.	_____	\$ _____	
						G.I.
						G.I.
			Pipe at		\$ _____	
	Nipples	in. at			\$ _____	
	Bushings	to in. at			\$ _____	
	Red'g	} Coupl'gs	to in. at		\$ _____	
	Inc'g					
	Union	in. at			\$ _____	
	Meter	in. at			\$ _____	
	Lead Joints	at			\$ _____	
	Compound Joints	at			\$ _____	
	Maintenance Foreman				\$ _____	
	Hrs. Water Maint. Man	1 at			\$ _____	
	Hrs. Water Maint. Man	2 at			\$ _____	
	Hrs. Garage Foreman	at			\$ _____	
	Hrs. Labor	at			\$ _____	
	Hrs. Compressor	at			\$ _____	
	Compensation Ins. at \$	per C			\$ _____	
	Trucking				\$ _____	
	Pav't Patch				\$ _____	
					\$ _____	
					\$ _____	
					\$ _____	
	O'head				\$ _____	
					\$ _____	

BAY St. Pt. Ave. No. 131

Name of Owner
TAX ID # 302.16-15-28

Labor and Mat'l. Report 19

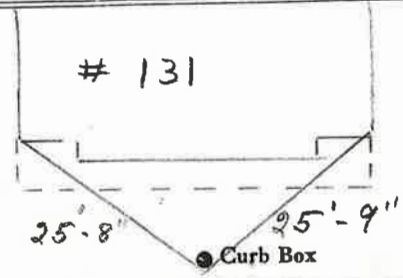

6 Main Elev. of Main at tap 5 1/2

Gate at • Gate at •

• Curb Box

BACKWARDS BOX-OFF
POSITION IS ON