


LABOR AND MATERIALS

1	Copper Lead	} Connection	3/4	\$
1	Curb			
1	Service box Old returned	{ Short 3 1/2 x 4 1/2 Long 4 1/2 x 5 1/2 Buff or Rdway		\$
31	Ft. 3/4 in.			
	Nipples	in. at	\$	
	Bushings	to in. at	\$	
	Red'g Inc'g	} Coupl'gs	to in. at	\$
	Union			
	Meter	in. at	\$	
	Lead Joints	at	\$	
	Compound Joints	at	\$	
	Maintenance Foreman		\$	
	Hrs. Water Maint. Man-1	at	\$	
	Hrs. Water Maint. Man-2	at	\$	
	Hrs. Garage Foreman	at	\$	
	Hrs. Labor	at	\$	
	Hrs. Compressor	at	\$	
	Compensation Ins. at \$	per C	\$	
	Trucking		\$	
	Pav't Patch		\$	
			\$	
			\$	
	O'head		\$	
			\$	

BAY St. PI. Ave. No. 138

Name of Owner
TAX ID # 302.16-12-13

Labor and Mat'l. Report 19

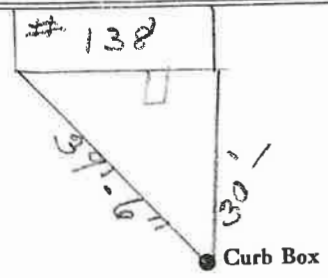

6" Main Elev. of Main at tap 5'
Gate at • Gate at •

• Curb Box