


LABOR AND MATERIALS

1	Copper	} Connection $\frac{3}{4}$	\$
1	Lead		\$
1	Curb	} $\frac{3}{4}$ in.	\$
	Cock		\$
	Valve T.S. & V.		\$
1	Service box	} { Short $3\frac{1}{2} \times 4\frac{1}{2}$ Long $4\frac{1}{2} \times 5\frac{1}{2}$ Buff or Rdway }	\$
	Old returned		\$
			\$
35	Ft. $\frac{3}{4}$ in.	} { Copper G.I. G.I. }	Pipe at \$
			\$
	Nipples	in. at	\$
	Bushings	to in. at	\$
	Red'g	} Coupl'gs	to in. at \$
	Inc'g		\$
	Union	in. at	\$
	Meter	in. at	\$
	Lead Joints	at	\$
	Compound Joints	at	\$
	Maintenance Foreman		\$
	Hrs. Water Maint. Man-1	at	\$
	Hrs. Water Maint. Man-2	at	\$
	Hrs. Garage Foreman	at	\$
	Hrs. Labor	at	\$
	Hrs. Compressor	at	\$
	Compensation Ins.	at \$ per C	\$
	Trucking		\$
	Pav't Patch		\$
			\$
			\$
	O'head		\$
			\$

St.
 Pl.
 Ave. No. 146
 Name of Owner BAY
 TAX ID # 302.16-12-17

Labor and Mat'l. Report 19

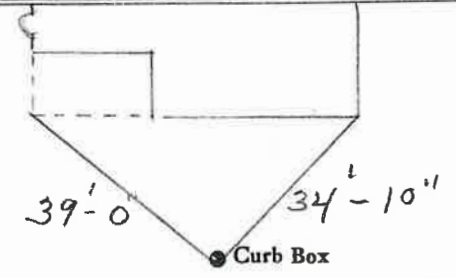

6" Main Elev. of Main at tap 5
 Gate at ● ● Gate at

● Curb Box