

LABOR AND MATERIALS

1	Copper	} Connection	3/4	\$	
1	Lead				
1	Curb	} Cock	3/4 in.	\$	
					} Valve
1	Service box	} Short 3 1/2 x 4 1/2		\$	
	Old returned				} Long 4 1/2 x 5 1/2
10	Ft. 3/4 in.	} Copper		\$	
					} C.I.
		} Pipe at		\$	
					} Nipples
		in. at		\$	
	Bushings	to	in. at	\$	
	Red'g	} Coupl'gs	to	in. at	\$
	Inc'g				
	Union	in. at		\$	
	Meter	in. at		\$	
	Lead Joints at			\$	
	Compound Joints at			\$	
	Maintenance Foreman			\$	
	Hrs. Water Maint. Man-1	at		\$	
	Hrs. Water Maint. Man-2	at		\$	
	Hrs. Garage Foreman	at		\$	
	Hrs. Labor	at		\$	
	Hrs. Compressor at			\$	
	Compensation Ins. at \$	per C		\$	
	Trucking			\$	
	Pav't Patch			\$	
				\$	
				\$	
				\$	
	O'head			\$	
				\$	


St. PI.
Ave. No. 147

BAY

Name of Owner

3/4" TAP COP. HUNTER & BAY

Labor and Mat'l. Report 19

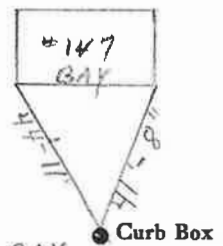

TAP ON BAY

6" Main

Elev. of Main at tap 5'

Gate at ● ● Gate at

TAX ID # 302.16-13-25

● Curb Box