

LABOR AND MATERIALS

1	Copper	} Connection	/ "	\$	
	Lead				
1	Curb	} Cock Valve T.S. & V.	in.	\$	
1	Service box	} Short 3 1/2 x 4 1/2		\$	
	Old returned				Long 4 1/2 x 5 1/2
					Buff. or Rdway
24	Ft. / "	} Copper G.I. C.I.	in.	\$	
					Pipe at
	Nipples	in. at	\$		
	Bushings	to in. at	\$		
	Red'g		\$		
	Inc'g	Coupl'gs to in. at	\$		
	Union	in. at	\$		
	Meter	in. at	\$		
	Lead Joints	at	\$		
	Compound Joints	at	\$		
	Maintenance Foreman		\$		
	Hrs. Water Maint. Man-1	at	\$		
	Hrs. Water Maint. Man-2	at	\$		
	Hrs. Garage Foreman	at	\$		
	Hrs. Labor	at	\$		
	Hrs. Compressor	at	\$		
	Compensation Ins.	at \$ per C	\$		
	Trucking		\$		
	Pav't Patch		\$		
			\$		
			\$		
	O'head		\$		
			\$		

St. PL
Ave. No. 149

BIAR


Name of Owner

TAX ID # 302.16-13-24

Labor and Mat'l. Report

19

1" RENEWAL TAP

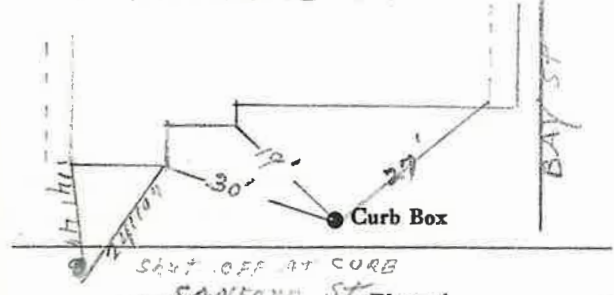

Main Elev. of Main at tap

Gate at • Gate at

24' to MAIN

• Curb Box

Two Taps


LABOR AND MATERIALS

1	Copper	} Connection	1"	\$
1	Lead			
1	Curb	} Cock Valve T.S. & V.	1/2 in.	\$
1	Service box			
Old returned	{ Short 3 1/2 x 4 1/2 } { Long 4 1/2 x 5 1/2 } { Buff or Rdway }			
24	Ft. / in.	{ Copper } { C.I. }	Pipe at	\$
	Nipples	in.	at	\$
	Bushings	to	in. at	\$
	Red'g	} Coupl'gs	to	in. at
	Inc'g			
	Union	in.	at	\$
	Meter	in.	at	\$
	Lead Joints	at		\$
	Compound Joints	at		\$
	Maintenance Foreman			\$
	Hrs. Water Maint. Man-1	at		\$
	Hrs. Water Maint. Man-2	at		\$
	Hrs. Garage Foreman	at		\$
	Hrs. Labor	at		\$
	Hrs. Compressor	at		\$
	Compensation Ins.	at \$	per C	\$
	Trucking			\$
	Pav't Patch			\$
				\$
				\$
	O'head			\$
				\$

BAY - St. Pt. Ave. No. 149

Name of Owner
DYKE

Labor and Mat'l. Report 19

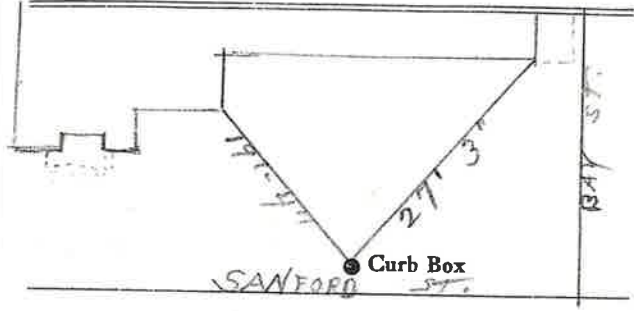

6" Main Elev. of Main at tap 5'

Gate at • Gate at

24' to MAIN

• Curb Box