


LABOR AND MATERIALS

1	Copper Lead	} Connection	3/4	\$	
1	Curb			} T.S. & V.	3/4 in.
1	Service box Old returned	} { Short 3 1/2 x 4 1/2 Long 4 1/2 x 5 1/2 Buff or Rdway }			
11	Ft.		} { Copper G.I. C.I. }	3/4 in.	Pipe at
	Nipples	in. at			\$
	Bushings	to in. at	\$		
	Red'g Inc'g	} Coupl'gs	to in. at	\$	
	Union			in. at	\$
	Meter	in. at	\$		
	Lead Joints	at	\$		
	Compound Joints	at	\$		
	Maintenance Foreman		\$		
	Hrs. Water Maint. Man	—1 at	\$		
	Hrs. Water Maint. Man	—2 at	\$		
	Hrs. Garage Foreman	at	\$		
	Hrs. Labor	at	\$		
	Hrs. Compressor	at	\$		
	Compensation Ins.	at \$ per C	\$		
	Trucking		\$		
	Pav't Patch		\$		
	O'head		\$		

St. Pl.
Ave. No. 153

Name of Owner _____
TAX ID # 302.16-7-10

Labor and Mat'l. Report 19

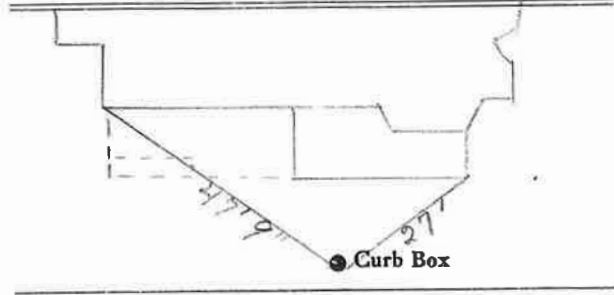

6 Main Elev. of Main at tap 5

Gate at • • Gate at
11' to main

• Curb Box