


LABOR AND MATERIALS

1	Copper Lead	} Connection	<u>3/4</u>		\$
1	Curb	} Cock Valve T.S. & V.	in.		\$
1	Service box Old returned	{ Short 3 1/2 x 4 1/2 Long 4 1/2 x 5 1/2 Buff or Rdway.			\$
<u>34</u>	<u>3/4</u> in.	{ Copper C.I. C.I.	} Pipe at		\$
	Nipples	in. at			\$
	Bushings	to in. at			\$
	Red'g Inc'g	} Coupl'gs	to in. at		\$
	Union	in. at			\$
	Meter	in. at			\$
	Lead Joints at				\$
	Compound Joints at				\$
	Maintenance Foreman				\$
	Hrs. Water Maint. Man—1 at				\$
	Hrs. Water Maint. Man—2 at				\$
	Hrs. Garage Foreman	at			\$
	Hrs. Labor	at			\$
	Hrs. Compressor at				\$
	Compensation Ins. at \$	per C			\$
	Trucking				\$
	Pav't Patch				\$
					\$
					\$
	O'head				\$
					\$

St.
Pl.
Ave. No. 154

Name of Owner

Labor and Mat'l. Report 19

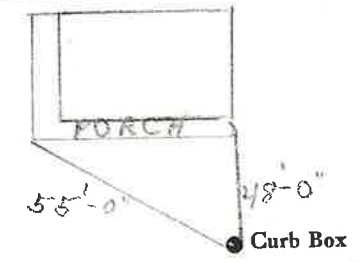

6' Main Elev. of
Main at tap 5'

Gate at ● ● Gate at

34' to MAIN

● Curb Box