

LABOR AND MATERIALS

1	Copper	} Connection $\frac{3}{4}$		\$	
	Lead				
1	Curb	} Cock } Valve } $\frac{3}{4}$ in.		\$	
			} T.S. & V.		
1	Service box	} Short $3\frac{1}{2} \times 4\frac{1}{2}$ } Long $4\frac{1}{2} \times 5\frac{1}{2}$ } Buff or Rdway }		\$	
	Old returned				
34	Ft. $\frac{3}{4}$ in.	} Copper } C.I. } C.I.	Pipe at	\$	
	Nipples			in. at	\$
	Bushings			to in. at	\$
	Red'g	} Coupl'gs	to in. at	\$	
	Ino'g				
	Union		in. at	\$	
	Meter		in. at	\$	
	Lead Joints at			\$	
	Compound Joints at			\$	
	Maintenance Foreman			\$	
	Hrs. Water Maint. Man—1 at			\$	
	Hrs. Water Maint. Man—2 at			\$	
	Hrs. Garage Foreman at			\$	
	Hrs. Labor— at			\$	
	Hrs. Compressor at			\$	
	Compensation Ins. at \$		per C	\$	
	Trucking			\$	
	Pav't Patch			\$	
				\$	
				\$	
	O'head			\$	
				\$	

BAY


St.  
Pl.  
Ave. No. 156

Name of Owner

TAX ID # 302.16-6-3

Labor and Mat'l. Report

19

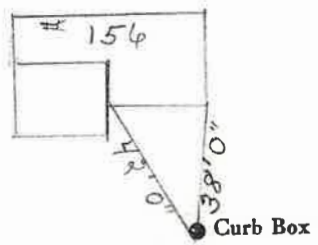

6" Main

Elev. of Main at tap  $\frac{4}{1}$

Gate at ●

● Gate at

34' to MAIN

● Curb Box