

LABOR AND MATERIALS


1	Copper Lead	Connection	$\frac{3}{4}$	\$
1	Curb	Cock Valve T.S. & V.	$\frac{3}{4}$ in.	\$
1	Service box	Short $3\frac{1}{2} \times 4\frac{1}{2}$		
	Old returned	Long $4\frac{1}{2} \times 5\frac{1}{2}$		
		Buff. or Rdway		\$
23	Ft. $\frac{3}{4}$ in.	Copper C.I. C.I.	Pipe at	\$
	Nipples	in. at		\$
	Bushings	to in. at		\$
	Red'g Inc'g	Coupl'gs to in. at		\$
	Union	in. at		\$
	Meter	in. at		\$
	Lead Joints	at		\$
	Compound Joints	at		\$
	Maintenance Foreman			\$
	Hrs. Water Maint. Man-1	at		\$
	Hrs. Water Maint. Man-2	at		\$
	Hrs. Garage Foreman	at		\$
	Hrs. Labor	at		\$
	Hrs. Compressor	at		\$
	Compensation Ins. at \$	per C		\$
	Trucking			\$
	Pav't Patch			\$
	O'head			\$

BAY

St. Pl. Ave. No. 159

Name of Owner
TAX ID # #302.16-7-7

Labor and Mat'l. Report 19

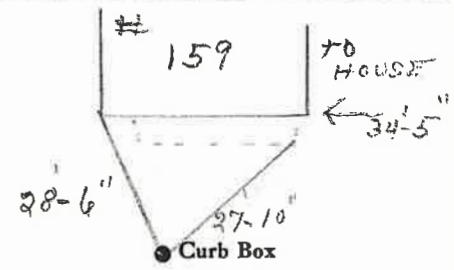

6" Main Elev. of Main at tap 6'

Gate at • Gate at

23' to MAIN

• Curb Box