


LABOR AND MATERIALS

1	Copper	} Connection	<u>3/4</u>	\$
	Lead			
1	Curb	} Cock Valve T.S. & V.	<u>3/4</u> in.	\$
1	Service box	} Short 3 1/2 x 4 1/2 Long 4 1/2 x 5 1/2 Buff. or Rdway		\$
	Old returned			
33	Ft. <u>3/4</u> in.	} Copper C.I. C.I.	} Pipe at	\$
	Nipples	in. at		\$
	Bushings	to in. at		\$
	Red'g Inc'g	} Coupl'gs	to in. at	\$
	Union	in. at		\$
	Meter	in. at		\$
	Lead Joints	at		\$
	Compound Joints	at		\$
	Maintenance Foreman			\$
	Hrs. Water Maint. Man	1 at		\$
	Hrs. Water Maint. Man	2 at		\$
	Hrs. Garage Foreman	at		\$
	Hrs. Labor	at		\$
	Hrs. Compressor	at		\$
	Compensation Ins.	at \$ per C		\$
	Trucking			\$
	Pav't Patch			\$
				\$
				\$
				\$
	O'head			\$
				\$

St. PI.
Ave. No. 1164
BAY
Name of Owner
TAX ID # 302.16-6-7

Labor and Mat'l. Report 19

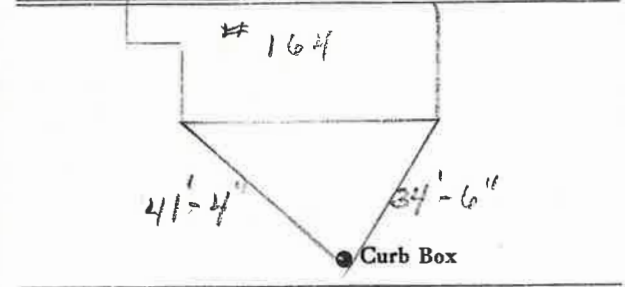

6 Main Elev. of Main at tap 5'

Gate at ● ● Gate at

● Curb Box