


LABOR AND MATERIALS

Copper } Connection _____ \$
 Lead }
 Curb } Cock } _____ in. \$
 } Valve }
 } T.S. & V. }
 Service box { Short 3-1/2 x 4-1/2 } _____ \$
 Old returned { Long 4-1/2 x 5-1/2 }
 Ft. _____ in. { Copper } Pipe at _____ \$
 { G.I. }
 { C.I. }
 Nipples _____ in. at _____ \$
 Bushings _____ to _____ in. at _____ \$
 Red'g _____
 Inc'g _____
 Union _____ in. at _____ \$
 Meter _____ in. at _____ \$
 _____ \$
 Compound Joints at _____ \$
 Maintenance Foreman _____ \$
 Hrs. Water Maint. Man - 1 at _____ \$
 Hrs. Water Maint. Man - 2 at _____ \$
 Hrs. Garage Foreman _____ at _____ \$
 Hrs. Labor _____ at _____ \$
 Hrs. Compressor at _____ \$
 _____ \$
 Trucking _____ \$
 Pav't Patch _____ \$
 _____ \$
 _____ \$
St. Bay St.
 Pl. Ave. No. 168

Name of Owner _____
 TAX ID # 302.16-6-9

Labor and Mat'l. Report 19

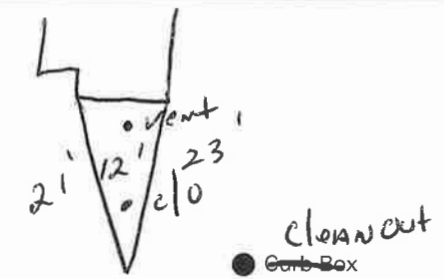

Main _____ Elev. of Main at tap _____
 Gate at ● _____ Gate at ● _____

● Curb Box
 L 21' R 23'
 From House
 12' From Vent pipe

LABOR AND MATERIALS

1	Copper Lead	Connection	$\frac{3}{4}$		\$
1	Curb	Cock Valve T.S. & V.	$\frac{3}{4}$ in.		\$
1	Service box Old returned	Short $3\frac{1}{2} \times 4\frac{1}{2}$ Long $4\frac{1}{2} \times 5\frac{1}{2}$ Buff or Rdway			\$
33	Ft. $\frac{3}{4}$ in.	Copper G.I. C.I.	Pipe at		\$
	Nipples	in. at			\$
	Bushings	to in. at			\$
	Red'g Inc'g	Coupl'gs to in. at			\$
	Union	in. at			\$
	Meter	in. at			\$
	Lead Joints	at			\$
	Compound Joints	at			\$
	Maintenance Foreman				\$
	Hrs. Water Maint. Man-1	at			\$
	Hrs. Water Maint. Man-2	at			\$
	Hrs. Garage Foreman	at			\$
	Hrs. Labor	at			\$
	Hrs. Compressor	at			\$
	Compensation Ins. at \$	per C			\$
	Trucking				\$
	Pav't Patch				\$
	O'head				\$


St.
Pl.
Ave. No. 168

BAY

Name of Owner

Labor and Mat'l. Report

19

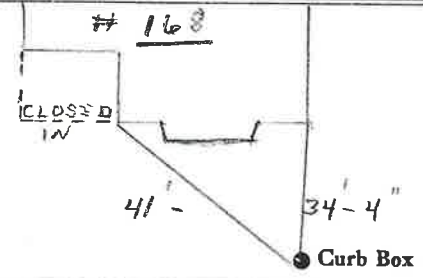

6" Main

Elev. of
Main at tap 5 $\frac{1}{2}$

Gate at ●

● Gate at

● Curb Box