


LABOR AND MATERIALS

1	Copper	} Connection	3/4"	\$	
1	Lead				
1	Curb	} Cock	3/4 in. Oriseat.	\$	
					Valve
		T.S. & V.			
1	Service box	} Short 3 1/2 x 4 1/2	\$		
	Old returned			Long 4 1/2 x 5 1/2	
				Buff or Rdway	
10	Ft. 3/4 in.	} Copper	Pipe at	\$	
					G.I.
					G.I.
	Nipples	in. at	\$		
	Bushings	to in. at	\$		
	Red'g	} Coupl'gs	to in. at	\$	
	Inc'g				
	Union	in. at	\$		
	Meter	in. at	\$		
	Lead Joints	at	\$		
	Compound Joints	at	\$		
	Maintenance Foreman		\$		
	Hrs. Water Maint. Man-1	at	\$		
	Hrs. Water Maint. Man-2	at	\$		
	Hrs. Garage Foreman	at	\$		
	Hrs. Labor	at	\$		
	Hrs. Compressor	at	\$		
	Compensation Ins. at \$	per C	\$		
	Trucking		\$		
	Pav't Patch		\$		
	Tap by Gifford & Co		\$		
	3-21-67		\$		
	O'head		\$		
			\$		

St. Big Cross Pt. 12 Ave. No. 12

Name of Owner Nudick.

Labor and Mat'l. Report Mar. 21 19 67

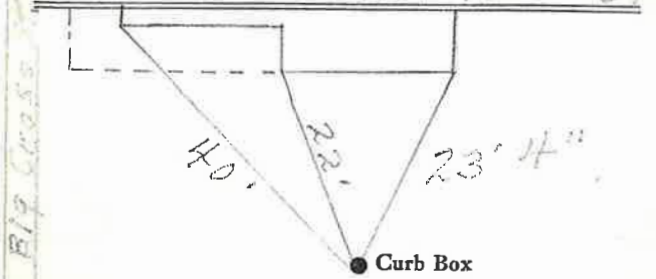

Second St.
6" Main Elev. of Main at tap 4 1/2'

Gate at • Gate at

TAX ID #309.12-7-20

• Curb Box
This Tap on Second St.