


LABOR AND MATERIALS

1	Copper	Connection	3/4"	\$
1	Curb	Cock	3/4 in. Cap. to Cap.	\$
1	Service box	Short 3 1/2 x 4 1/2		\$
	Old returned	Long 5 1/2		\$
		Half or Rdway		\$
11	Ft.	Copper	3/4 in.	Pipe at \$
	Nipples	in. at		\$
	Bushings	to in. at		\$
	Red'g			\$
	Inc'g	Coupl'gs to in. at		\$
	Union	in. at		\$
	Meter	in. at		\$
	Lead Joints	at		\$
	Compound Joints	at		\$
	Maintenance Foreman			\$
	Hrs. Water Maint. Man-1	at		\$
	Hrs. Water Maint. Man-2	at		\$
	Hrs. Garage Foreman	at		\$
	Hrs. Labor	at		\$
	Hrs. Compressor	at		\$
	Compensation Ins. at \$	per C		\$
	Trucking			\$
	Pav't Patch			\$
	TAP BY Beecher & Co.			\$
	DEC-2-1974			\$
	O'head			\$
				\$

St. Big Cross  
 Ave. No. 18  
 Name of Owner Bolster

Labor and Mat'l. Report Dec. 2 1974

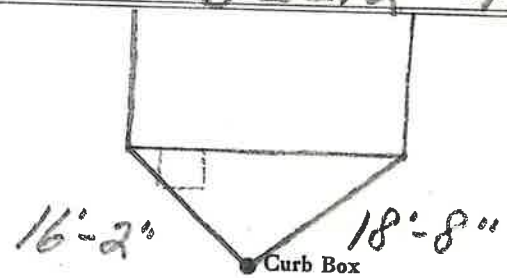

4" Main      Elev. of Main at tap 5 1/2'

Gate at ●      ● Gate at

TAX ID # 309.12-10-25

● Curb Box