

Labor and Materials


Copper	}	Connection.....	\$		
Lead					
Curb	}	Cock Valve	in	\$	
		T. S. & V.			
Service-Box		Short 3 1/2 x 4 1/2	}	\$	
Old returned	Long 4 1/2 x 5 1/2				
		Buff. or Rdway			
Ft. in.	}	Copper	}	Pipe at	\$
		Galv Iron			
		Cast Iron			
Nipples		in. at		\$	
Bushings		to	in. at	\$	
Red'g	}	Conplings.....	to	in. at	\$
Inc'g					
Union		in. at		\$	
Meter		in. at		\$	
Lead Joints		at		\$	
Leadite Joints		at		\$	
Hrs. Foreman		at		\$	
Hrs. Chauffeur		at		\$	
Hrs. Tapper		at		\$	
Hrs. Labor		at		\$	
Hrs. Labor		at		\$	
Hrs. Compressor		at		\$	
Compensation Ins.				\$	
Trucking				\$	
Builders Use of Water				\$	
				\$	
				\$	
St.
Pl. Ave. No. 9

Big Cross

Name of Owner
Mrs. Wesley Norton

Labor and Mat'l. Report 7-5-16 19

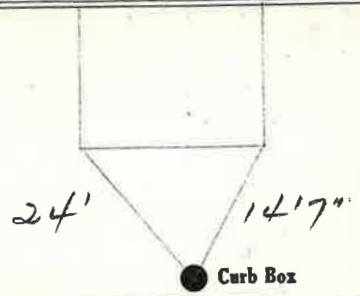

4 Main Elev. of Main at tap.....

Gate at ● ● Gate at

TAX ID # 309.11-7-2

● Curb Box