

LABOR AND MATERIALS


1	Copper	} Connection	3/4"	\$	
	head				
1	Curb	} Cock	3/4 in.	\$	
					Valve
					P.S. & V.
1	Service box	} Short 3 1/2 x 4 1/2		\$	
	Old returned				Long 4 1/2 x 5 1/2
					Buf. or Midway
10	Ft. 3/4 in.	} Copper		\$	
					Gal.
		Gal.			
			Pipe at	\$	
	Nipples	in. at		\$	
	Bushings	to in. at		\$	
	Red'g	} Coupl'gs	to in. at	\$	
	Inc'g				
	Union	in. at		\$	
	Meter	in. at		\$	
	Lead Joints	at		\$	
	Compound Joints	at		\$	
	Maintenance Foreman			\$	
	Hrs. Water Maint. Man-1	at		\$	
	Hrs. Water Maint. Man-2	at		\$	
	Hrs. Garage Foreman	at		\$	
	Hrs. Labor-	at		\$	
	Hrs. Compressor	at		\$	
	Compensation Ins. at \$	per C		\$	
	Trucking			\$	
	Pav't Patch			\$	
	Tap Made By St John's Co			\$	
	Aug 24-1973			\$	
	O'head			\$	
				\$	

St. 11
Big Cross Ave. No. 11
 Name of Owner

John Lyford

Labor and Mat'l. Report

Aug 24 1973

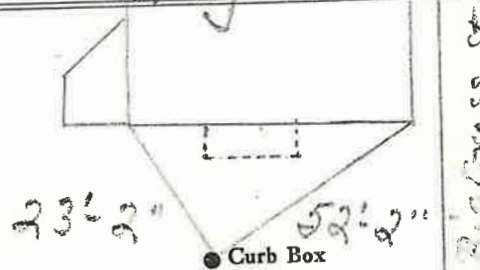

Second St
 6" Main

Elev. of Main at tap 5'

Gate at •

• Gate at

TAX ID # 309.11-7-1

• Curb Box

Tap on Second St