


LABOR AND MATERIALS

1	Copper	} Connection	3/4	_____	\$ _____	
	Lead					
1	Curb	} Cock	} 3/4	} in.	\$ _____	
						} Valve
SEE	Service box	} Short 3 1/2 x 4 1/2	}	_____	\$ _____	
Old	returned					} Long 4 1/2 x 5 1/2
16	Ft.	} Copper	} 3/4	} in.	} Pipe at _____	
						} C.I.
		} C.I.	}	_____	\$ _____	
	Nipples					in. at _____
	Bushings	to _____ in. at _____	\$ _____			
	Red'g	} Coupl'gs	} to _____	} in. at _____	\$ _____	
	Inc'g					
	Union	in. at _____	\$ _____			
	Meter	in. at _____	\$ _____			
	Lead Joints	at _____	\$ _____			
	Compound Joints	at _____	\$ _____			
	Maintenance Foreman	_____	\$ _____			
	Hrs. Water Maint. Man—1	at _____	\$ _____			
	Hrs. Water Maint. Man—2	at _____	\$ _____			
	Hrs. Garage Foreman	at _____	\$ _____			
	Hrs. Labor—	at _____	\$ _____			
	Hrs. Compressor	at _____	\$ _____			
	Compensation Ins. at \$ _____	per C. _____	\$ _____			
	Trucking	_____	\$ _____			
	Pav't Patch	_____	\$ _____			
		_____	\$ _____			
		_____	\$ _____			
	O'head	_____	\$ _____			
		_____	\$ _____			

BIRCH St. PL. Ave. No. 7

Name of Owner _____

Labor and Mat'l. Report 19

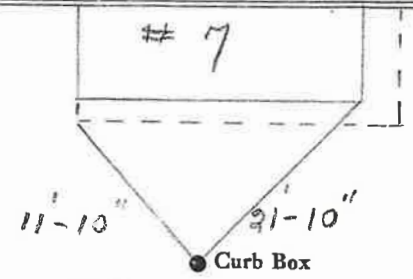

4" Main Elev. of Main at top 5 1/2

Gate at • • Gate at

• Curb Box

TAX ID #302.20-6-18