


LABOR AND MATERIALS

1	Copper Lead	Connection	3/4"	\$
1	Curb	Cock Valve T.S. & V.	3/4" in.	\$
1	Service box Old returned	Short 3 1/2 x 4 1/2 Long 4 1/2 x 5 1/2		\$
21'	Ft.	Copper C.I. Pipe at	3/4" in.	\$
	Nipples	in. at		\$
	Bushings	to in. at		\$
	Red'g Inc'g	Coupl'gs to in. at		\$
	Union	in. at		\$
	Meter	in. at		\$
	Compound Joints	at		\$
	Maintenance Foreman			\$
	Hrs. Water Maint. Man-1	at		\$
	Hrs. Water Maint. Man-2	at		\$
	Hrs. Garage Foreman	at		\$
	Hrs. Labor	at		\$
	Hrs. Compressor	at		\$
	Trucking			\$
	Pav't Patch			\$
				\$
				\$
St. BIRCH
 Pt. Ave. No. 17

Name of Owner _____

Labor and Mat'l. Report JULY 1933

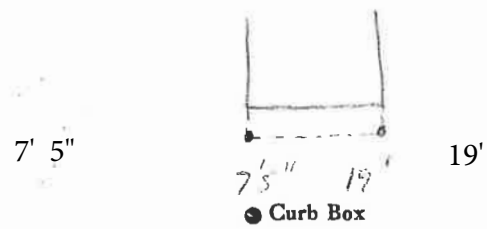

4" Main Elev. of Main at tap 6'

Gate at ● ● Gate at

TAX ID # 302.20-6-13

● Curb Box
 - OLD TAP SHUT OFF AT MAIN
 - CURB BOX INSIDE SWK