


LABOR AND MATERIALS

1	Copper	} Connection	3/4"	_____	\$ _____
	Lead				
1	Curb	} Cock Valve	3/4" in.	_____	\$ _____
1	Service box	} Short 3 1/2 x 4 1/2	_____	_____	\$ _____
	Old returned				
20	Ft.	} Copper	3/4" in.	_____	\$ _____
		} Pipe at	_____	_____	\$ _____
	Nipples	_____ in.	_____ at	_____	\$ _____
	Bushings	_____ to _____	_____ in.	_____ at	\$ _____
	Red'g	} Coupl'gs	_____ to _____	_____ in.	_____ at
	Inc'g				
	Union	_____ in.	_____ at	_____	\$ _____
	Meter	_____ in.	_____ at	_____	\$ _____
	Compound Joints	_____ at	_____	_____	\$ _____
	Maintenance Foreman	_____ at	_____	_____	\$ _____
	Hrs. Water Maint. Man-1	_____ at	_____	_____	\$ _____
	Hrs. Water Maint. Man-2	_____ at	_____	_____	\$ _____
	Hrs. Garage Foreman	_____ at	_____	_____	\$ _____
	Hrs. Labor	_____ at	_____	_____	\$ _____
	Hrs. Compressor	_____ at	_____	_____	\$ _____
	Trucking	_____ at	_____	_____	\$ _____
	Pav't Patch	_____ at	_____	_____	\$ _____
					\$ _____
					\$ _____
BIRCH Str. _____
 Pl. _____
 Ave. No. 19

Name of Owner _____

Labor and Mat'l. Report SEPT. 1927

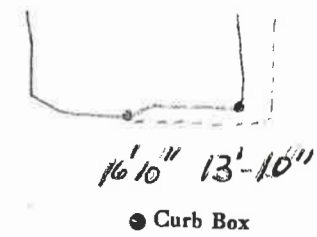

4" Main Elev. of Main at tap 6 1/2'
 Gate at ● Gate at ●

20' to main
3/4" copper ● Curb Box

TAX ID # 302.20-6-12