


LABOR AND MATERIALS

1	Copper Lead	} Connection	3/4"	\$	
1	Curb			} Cock Valve T.S. & V.	3/4" in.
1	Service box Old returned	} Short 3 1/2 x 4 1/2 Long 4 1/2 x 5 1/2			
12	Ft.		} Copper C.I. C.I.	3/4" in.	Pipe at
	Nipples	in. at			\$
	Bushings	to	in. at	\$	
	Red'g Inc'g	} Coupl'gs	to	in. at	\$
	Union				
	Meter	in. at	\$		
	Compound Joints	at	\$		
	Maintenance Foreman		\$		
	Hrs. Water Maint. Man-1	at	\$		
	Hrs. Water Maint. Man-2	at	\$		
	Hrs. Garage Foreman	at	\$		
	Hrs. Labor	at	\$		
	Hrs. Compressor	at	\$		
	Trucking		\$		
	Pav't Patch		\$		
			\$		
			\$		
BIRCH St. PH Ave. No. 20  
 Name of Owner

Labor and Mat'l. Report AUG 19 32

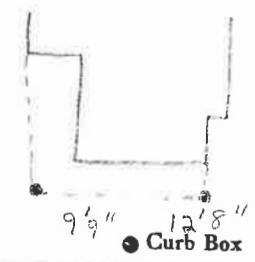

4" Main Elev. of Main at tap 6 1/2'

Gate at • Gate at •

TAX ID # 302.16-18-16

• Curb Box

OLD TAP SHUT OFF AT MAIN