

LABOR AND MATERIALS


1	Copper Lead	Connection	3/4"	\$	3.08
1	Curb	Cock Valve T.S. & V.	3/4 in.	\$	3.89
1	Service box	Short 3 1/2 x 4 1/2			
21	Old returned	Long 4 1/2 x 5 1/2		\$	4.32
24	Ft. 3/4 in.	Copper G.I. C.I. } Pipe at	45	\$	10.80
	Nipples	in. at		\$	
	Bushings	to in. at		\$	
	Red'g Inc'g	Coupl'gs to in. at		\$	
	Union	in. at		\$	
	Meter	in. at		\$	
	Lead Joints	at		\$	
	Compound Joints	at		\$	
3	Maintenance Foreman		1.937	\$	5.81
	Hrs. Water Maint. Man	1 at		\$	
4	Hrs. Water Maint. Man	2 at	1.613	\$	6.45
2	Hrs. Garage Foreman	lab at	1.481	\$	2.96
16	Hrs. Labor	at	1.30	\$	20.50
	Hrs. Compressor	at		\$	
	Compensation Ins.	at \$5.686 per C.		\$	3.05
	Trucking			\$	1.50
	Pay't Patch	Before Paving		\$	
	Tap by	Gifford & Co.		\$	
		6-21-56		\$	
	O'head			\$	
				\$	61.66

Birch

St Pl Ave. No. 21

Name of Owner
Joseph Jomier

Labor and Mat'l. Report June 21 19 56

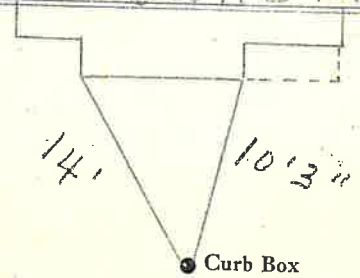

4" Main Elev. of Main at tap 5 1/2'

Gate at • Gate at

TAX ID # 302.20-6-11

• Curb Box

Before Paving