

## LABOR AND MATERIALS

1	Copper	Connection	3/4"		\$ 3.04
	Lead				
1	Curb	Cock Valve F.S. & V.	3/4" in.		\$ 3.54
1	Service box Old returned	Short 3 1/2 x 4 1/2 Long 4 1/2 x 5 1/2 Buff or Rdway			\$ 4.70
9	Ft.	Copper G.I. G.I.	3/4 in.	Pipe at 35	\$ 3.15
	Nipples	in. at			\$
	Bushings	to in. at			\$
	Red'g	Coupl'gs to in. at			\$
	Inc'g				\$
	Union	in. at			\$
	Meter	in. at			\$
	Lead Joints at				\$
	Compound Joints at				\$
	Hrs. Water Maint. Man-1 at				\$
8	Hrs. Water Maint. Man-2 at		1.13		\$ 9.04
12	Hrs. Labor	at	1.02		\$ 12.24
	Hrs. Labor	at			\$
	Hrs. Compressor at				\$
	Compensation Ins. at	\$ 266 per C.			\$ 57
	Trucking				\$ 1.06
	Pav't Patch				\$ 12.60
	Tap by Warsinski				\$
	O'head				\$
					\$ 49.88

11-1951

Birch


St.   
 Pl.   
 Ave. No. 222

Name of Owner

Wynn

Labor and Mat'l. Report

Dec 12, 1950

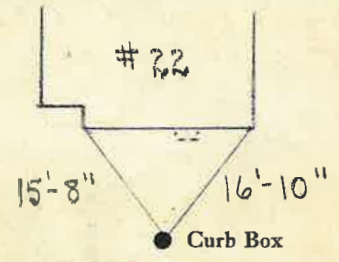

4" Main

Elev. of Main at tap 7'

Gate at ●

● Gate at

TAX ID #302.16-18-17

● Curb Box