

LABOR AND MATERIALS

1	Copper	} Connection	_____	\$ _____	
	Lead				
1	Curb	} Cock Valve T.S. & V.	_____ in.	\$ _____	
1	Service box	} Short 3 1/2 x 4 1/2 Long 4 1/2 x 5 1/2 Buff or Rdway	_____	\$ _____	
	Old returned				
21	Ft. 3/4 in.	} Copper C.I. C.I.	Pipe at _____	\$ _____	
	Nipples _____ in.			at _____	\$ _____
	Bushings _____ to _____ in.			at _____	\$ _____
	Red'g } Inc'g }	} Coupl'gs _____ to _____ in.	at _____	\$ _____	
	Union _____ in.			at _____	\$ _____
	Meter _____ in.		at _____	\$ _____	
	Lead Joints at _____			\$ _____	
	Compound Joints at _____			\$ _____	
	Maintenance Foreman _____			\$ _____	
	Hrs. Water Maint. Man—1 at _____			\$ _____	
	Hrs. Water Maint. Man—2 at _____			\$ _____	
	Hrs. Garage Foreman _____ at _____			\$ _____	
	Hrs. Labor— _____ at _____			\$ _____	
	Hrs. Compressor at _____			\$ _____	
	Compensation Ins. at \$ _____ per C _____			\$ _____	
	Trucking _____			\$ _____	
	Pav't Patch _____			\$ _____	
	_____			\$ _____	
	_____			\$ _____	
	_____			\$ _____	
	O'head _____			\$ _____	
	_____			\$ _____	


Birch

St. _____
Pl. _____
Ave. No. 9

Name of Owner _____

Labor and Mat'l. Report

19

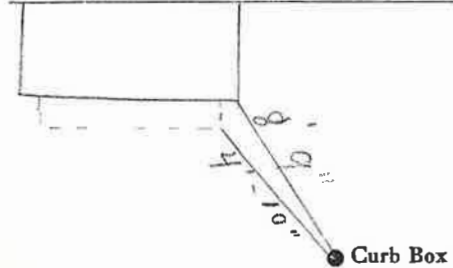

4" Main

Elev. of Main at tap 5 1/2

Gate at ●

● Gate at

TAX ID # 302.20-6-17

● Curb Box