

LABOR AND MATERIALS

1	Copper	} Connection	3/4"	\$	3.08
1	Lead				
1	Curb	} Cock Valve T.S. & V.	} 3/4 in.	\$	3.89
1	Service box				
	Old returned	} Short 3 1/2 x 4 1/2 Long 4 1/2 x 5 1/2 Buff or Rdway.		\$	4.32
24	Ft. 3/4 in.				
		} Copper C.I. C.I.	} Pipe at 45	\$	10.80
	Nipples	in. at		\$	
	Bushings	to in. at		\$	
	Red'g Inc'g	Coupl'gs to in. at		\$	
	Union	in. at		\$	
	Meter	in. at		\$	
	Lead Joints	at		\$	
	Compound Joints	at		\$	
4	Maintenance Foreman	1.937		\$	7.75
	Hrs. Water Maint. Man	1 at		\$	
	Hrs. Water Maint. Man	2 at		\$	
4	Hrs. Garage Foreman	1.491		\$	5.92
4	Hrs. Labor	at 1.30		\$	5.20
	Hrs. Compressor at			\$	
	Compensation Ins. at	5.696 per C		\$	1.07
	Trucking			\$	1.50
	Pav't Patch			\$	
	Tap by Gifford & Cp			\$	
		6-21-56		\$	
	O'head			\$	
				\$	43.53

Birch


St. Pt. Ave. No. 13

Name of Owner

Robert Barrett

Labor and Mat'l. Report

June 21 1956

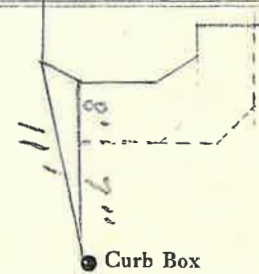

4" Main

Elev. of Main at tap 5 1/2'

Gate at ●

● Gate at

● Curb Box

TAX ID # 302.20-6-15

Before Paving.