


LABOR AND MATERIALS

3/4" Copper } Connection _____ \$ _____
 lead }
 Curb } Cock _____ in. _____ \$ _____
 Valve }
 T.S. & V. }
 Service box { Short 3-1/2 x 4-1/2 } _____ \$ _____
 Old returned { Long 4-1/2 x 5-1/2 }
 2' Ft. 6 in. { Copper } Pipe at _____ \$ _____
 { C.I. }
 { C.I. }
 Nipples _____ in. at _____ \$ _____
 Bushings _____ to _____ in. at _____ \$ _____
 Red'g _____
 Inc'g _____
 Union _____ in. at _____ \$ _____
 Meter _____ in. at _____ \$ _____
 _____ \$ _____
 Compound Joints at _____ \$ _____
 Maintenance Foreman _____ \$ _____
 Hrs. Water Maint. Man - 1 at _____ \$ _____
 Hrs. Water Maint. Man - 2 at _____ \$ _____
 Hrs. Garage Foreman _____ at _____ \$ _____
 Hrs. Labor _____ at _____ \$ _____
 Hrs. Compressor at _____ \$ _____
 _____ \$ _____
 Trucking _____ \$ _____
 Pav't Patch _____ \$ _____
 _____ \$ _____
 _____ \$ _____
 _____ \$ _____
 _____ \$ _____

St. _____
 Pl. Ave. No. 36
 W Boylston
 Name of Owner
 New Part
 Labor and Mat'l. Report 2006

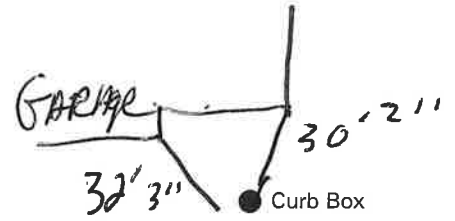

0 Main Elev. of Main at tap 5
 Gate at ● Gate at ●
 ● Curb Box

THIS ONE BY WATER
 L 30' 10" R 27' 6"
 sewer
 TWO CLEAR OUT