

LABOR AND MATERIALS

_____	Copper	} Connection	_____	\$	
_____	Lead		_____	\$	
_____	Curb	} Cock Valve T.S. & V.	_____ in.	\$	
_____			Service box	} Short 3-1/2 x 4-1/2	_____ \$
_____					Old returned
<u>15</u>	Ft. <u>0</u> in.	} <u>Copper</u> G.I. C.I.	Pipe at <u>3/4"</u>	\$	
_____	Nipples _____ in. at _____		_____	\$	
_____	Bushings _____ to _____ in. at _____	_____	\$		
_____	Red'g _____	_____	\$		
_____	Inc'g _____	_____	\$		
_____	Union _____ in. at _____	_____	\$		
_____	Meter _____ in. at _____	_____	\$		
_____	_____	_____	\$		
_____	Compound Joints at _____	_____	\$		
_____	Maintenance Foreman _____	_____	\$		
_____	Hrs. Water Maint. Man - 1 at _____	_____	\$		
_____	Hrs. Water Maint. Man - 2 at _____	_____	\$		
_____	Hrs. Garage Foreman _____ at _____	_____	\$		
_____	Hrs. Labor _____ at _____	_____	\$		
_____	Hrs. Compressor at _____	_____	\$		
_____	_____	_____	\$		
_____	Trucking _____	_____	\$		
_____	Pav't Patch _____	_____	\$		
_____	_____	_____	\$		
_____	_____	_____	\$		
_____	_____	_____	\$		
_____	_____	_____	\$		


WEST
BOYLSTON

St. 58
Pl. 58
Ave. No.

Name of Owner

LOT # 21


Labor and Mat'l. Report 19

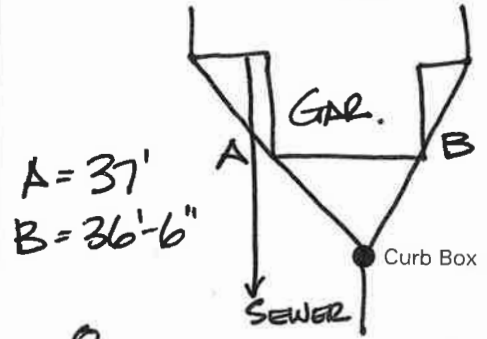

8 Main Elev. of Main at tap 4.75'

Gate at ● Gate at ●

TAX ID # 309.15-16-21

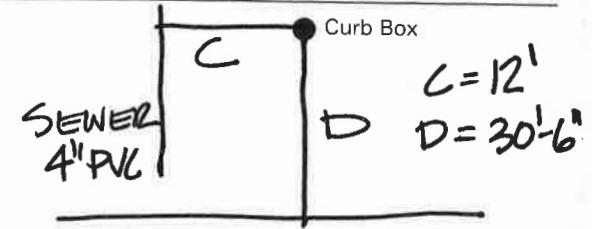

BOYLSTON