

LABOR AND MATERIALS


_____	Copper	} Connection	_____	\$ _____
_____	Lead			
_____	Curb	} Cock } Valve } T.S. & V.	_____ in.	\$ _____
_____	Service box		} Short 3-1/2 x 4-1/2 } Long 4-1/2 x 5-1/2	_____
_____	Old returned			
50.7'	Ft.	} Copper } G.I. } C.I.	3/4 in.	Pipe at _____ \$ _____
_____	Nipples		_____ in.	at _____ \$ _____
_____	Bushings	_____ to _____ in.	at _____ \$ _____	
_____	Red'g			
_____	Inc'g			
_____	Union	_____ in.	at _____ \$ _____	
_____	Meter	_____ in.	at _____ \$ _____	
_____				\$ _____
_____	Compound Joints at			\$ _____
_____	Maintenance Foreman			\$ _____
_____	Hrs. Water Maint. Man - 1 at			\$ _____
_____	Hrs. Water Maint. Man - 2 at			\$ _____
_____	Hrs. Garage Foreman	_____ at		\$ _____
_____	Hrs. Labor	_____ at		\$ _____
_____	Hrs. Compressor at			\$ _____
_____				\$ _____
_____	Trucking			\$ _____
_____	Pav't Patch			\$ _____
_____				\$ _____
_____				\$ _____
_____				\$ _____

West
BOYLSTON

St
Pl. Ave. No. 59
LOT 12

Name of Owner
TAX ID # 309.15-16-12

Labor and Mat'l. Report ~~12~~ DEC. 30, 2003

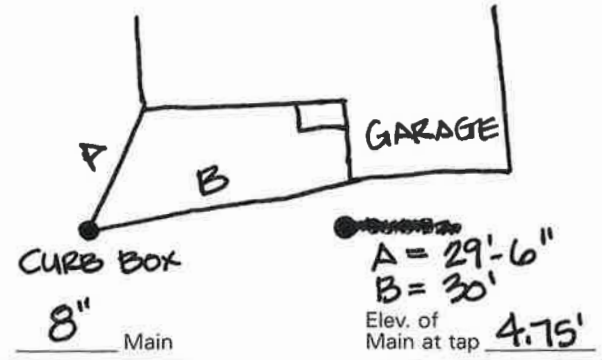

Gate at ● Gate at ●

