

LABOR AND MATERIALS

| | |
|---|--------------|
| <u>3/4</u> Copper } Connection _____ \$ | |
| Lead } _____ \$ | |
| Curb } Cock Valve } _____ in. \$ | |
| | T. S. & V. } |
| Service box } Short 3 1/2 x 4 1/2 } _____ \$ | |
| Old returned } Long 4 1/2 x 5 1/2 } _____ \$ | |
| Ft. <u>3/4</u> in. } Copper } Pipe at _____ \$ | |
| | G. I. } |
| | G. I. } |
| Nipples _____ in. at _____ \$ | |
| Bushings _____ to _____ in. at _____ \$ | |
| Red'g } Coupl'gs _____ to _____ in. at _____ \$ | |
| Inc'g } | |
| Union _____ in. at _____ \$ | |
| Meter _____ in. at _____ \$ | |
| _____ \$ | |
| Compound Joints at _____ \$ | |
| Maintenance Foreman _____ \$ | |
| Hrs. Water Maint. Man-1 at _____ \$ | |
| Hrs. Water Maint. Man-2 at _____ \$ | |
| Hrs. Garage Foreman _____ at _____ \$ | |
| Hrs. Labor _____ at _____ \$ | |
| Hrs. Compressor at _____ \$ | |
| _____ \$ | |
| Trucking _____ \$ | |
| Pav't Patch _____ \$ | |
| _____ \$ | |
| _____ \$ | |

24E. BOYLSTON

St. Pl. Ave. No. 24

Name of Owner _____

Labor and Mat'l. Report _____

1996

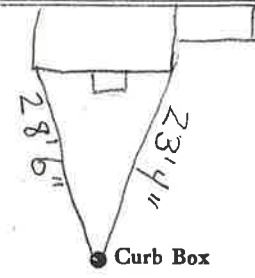

Main _____ Elev. of Main at tap _____

Gate at • _____ • Gate at _____

NO HOUSE AT
THIS ADDRESS
June 28, 2000