


# LABOR AND MATERIALS

3/4 Copper } Connection \_\_\_\_\_ \$ \_\_\_\_\_  
 Curb }  
 Cock } \_\_\_\_\_ in. \_\_\_\_\_ \$ \_\_\_\_\_  
 Valve }  
 T.S. & V. }  
 Service box { Short 3-1/2 x 4-1/2 } \_\_\_\_\_ \$ \_\_\_\_\_  
 Old returned { Long 4-1/2 x 5-1/2 } \_\_\_\_\_ \$ \_\_\_\_\_  
 ABOUT 7.7  
 136 Ft. in. Copper } Pipe at \_\_\_\_\_ \$ \_\_\_\_\_  
 G.I.  
 C.I. }  
 Nipples \_\_\_\_\_ in. at \_\_\_\_\_ \$ \_\_\_\_\_  
 Bushings \_\_\_\_\_ to \_\_\_\_\_ in. at \_\_\_\_\_ \$ \_\_\_\_\_  
 Red'g \_\_\_\_\_  
 Inc'g \_\_\_\_\_  
 Union \_\_\_\_\_ in. at \_\_\_\_\_ \$ \_\_\_\_\_  
 Meter \_\_\_\_\_ in. at \_\_\_\_\_ \$ \_\_\_\_\_  
 Compound Joints at \_\_\_\_\_ \$ \_\_\_\_\_  
 Maintenance Foreman Tony Messia \_\_\_\_\_ \$ \_\_\_\_\_  
 Hrs. Water Maint. Man - 1 at \_\_\_\_\_ \$ \_\_\_\_\_  
 Hrs. Water Maint. Man - 2 at \_\_\_\_\_ \$ \_\_\_\_\_  
 Hrs. Garage Foreman \_\_\_\_\_ at \_\_\_\_\_ \$ \_\_\_\_\_  
 Hrs. Labor \_\_\_\_\_ at \_\_\_\_\_ \$ \_\_\_\_\_  
 Hrs. Compressor at \_\_\_\_\_ \$ \_\_\_\_\_  
 \_\_\_\_\_ \$ \_\_\_\_\_  
 Trucking \_\_\_\_\_ \$ \_\_\_\_\_  
 Pav't Patch \_\_\_\_\_ \$ \_\_\_\_\_  
 \_\_\_\_\_ \$ \_\_\_\_\_  
 \_\_\_\_\_ \$ \_\_\_\_\_  
St. \_\_\_\_\_  
 Pl. \_\_\_\_\_  
 Ave. No. 25  
 Name of Owner \_\_\_\_\_  
JAMIE WRIGHT  
 Labor and Mat'l. Report 5/6/2009

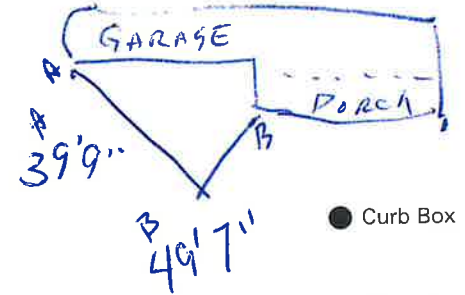

Main \_\_\_\_\_ Elev. of Main at tap \_\_\_\_\_  
 Gate at ● \_\_\_\_\_ Gate at ● \_\_\_\_\_

THIS LINE HAS A COUPLING  
 90' OFF CURB BOX - NEW  
 COUPLING 5/6/09 - 3/4" LINE  
 CONNECTED TO MAIN TOWARD  
 HYDRANT - PRIVATE CONTRACTOR  
 INSTALLED MAIN