

2

LABOR AND MATERIALS


Copper	Lead	Connection	3/4"		\$
1	Curb	Cock Valve T.S. & V.	3/4 in.		\$
1	Service box Old returned	Short 3 1/2 x 4 1/2 Long 4 1/2 x 5 1/2 Buff or Rdway.			\$
30	Ft.	3/4 in.	Copper G.I. C.I.	Pipe at	\$
	Nipples	in.		at	\$
	Bushings	to	in.	at	\$
	Red'g Inc'g	Coupl'gs	to	in.	\$
	Union	in.		at	\$
	Meter	in.		at	\$
	Lead Joints			at	\$
	Compound Joints			at	\$
	Maintenance Foreman				\$
	Hrs. Water Maint. Man-1			at	\$
	Hrs. Water Maint. Man-2			at	\$
	Hrs. Garage Foreman			at	\$
	Hrs. Labor			at	\$
	Hrs. Compressor			at	\$
	Compensation Ins.	at \$		per C	\$
	Trucking				\$
	Pav't Patch				\$
					\$
					\$
					\$
	O'head				\$
					\$

St. 7
~~Pl.~~
Ave. No. 7

WEST BOYLSTON

Name of Owner _____

Labor and Mat'l. Report 19

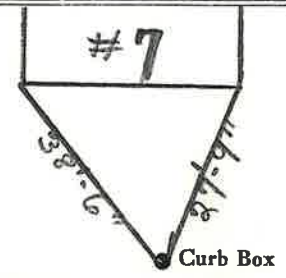

6" Main Elev. of Main at top 1 1/2

Gate at ● ● Gate at

● Curb Box